


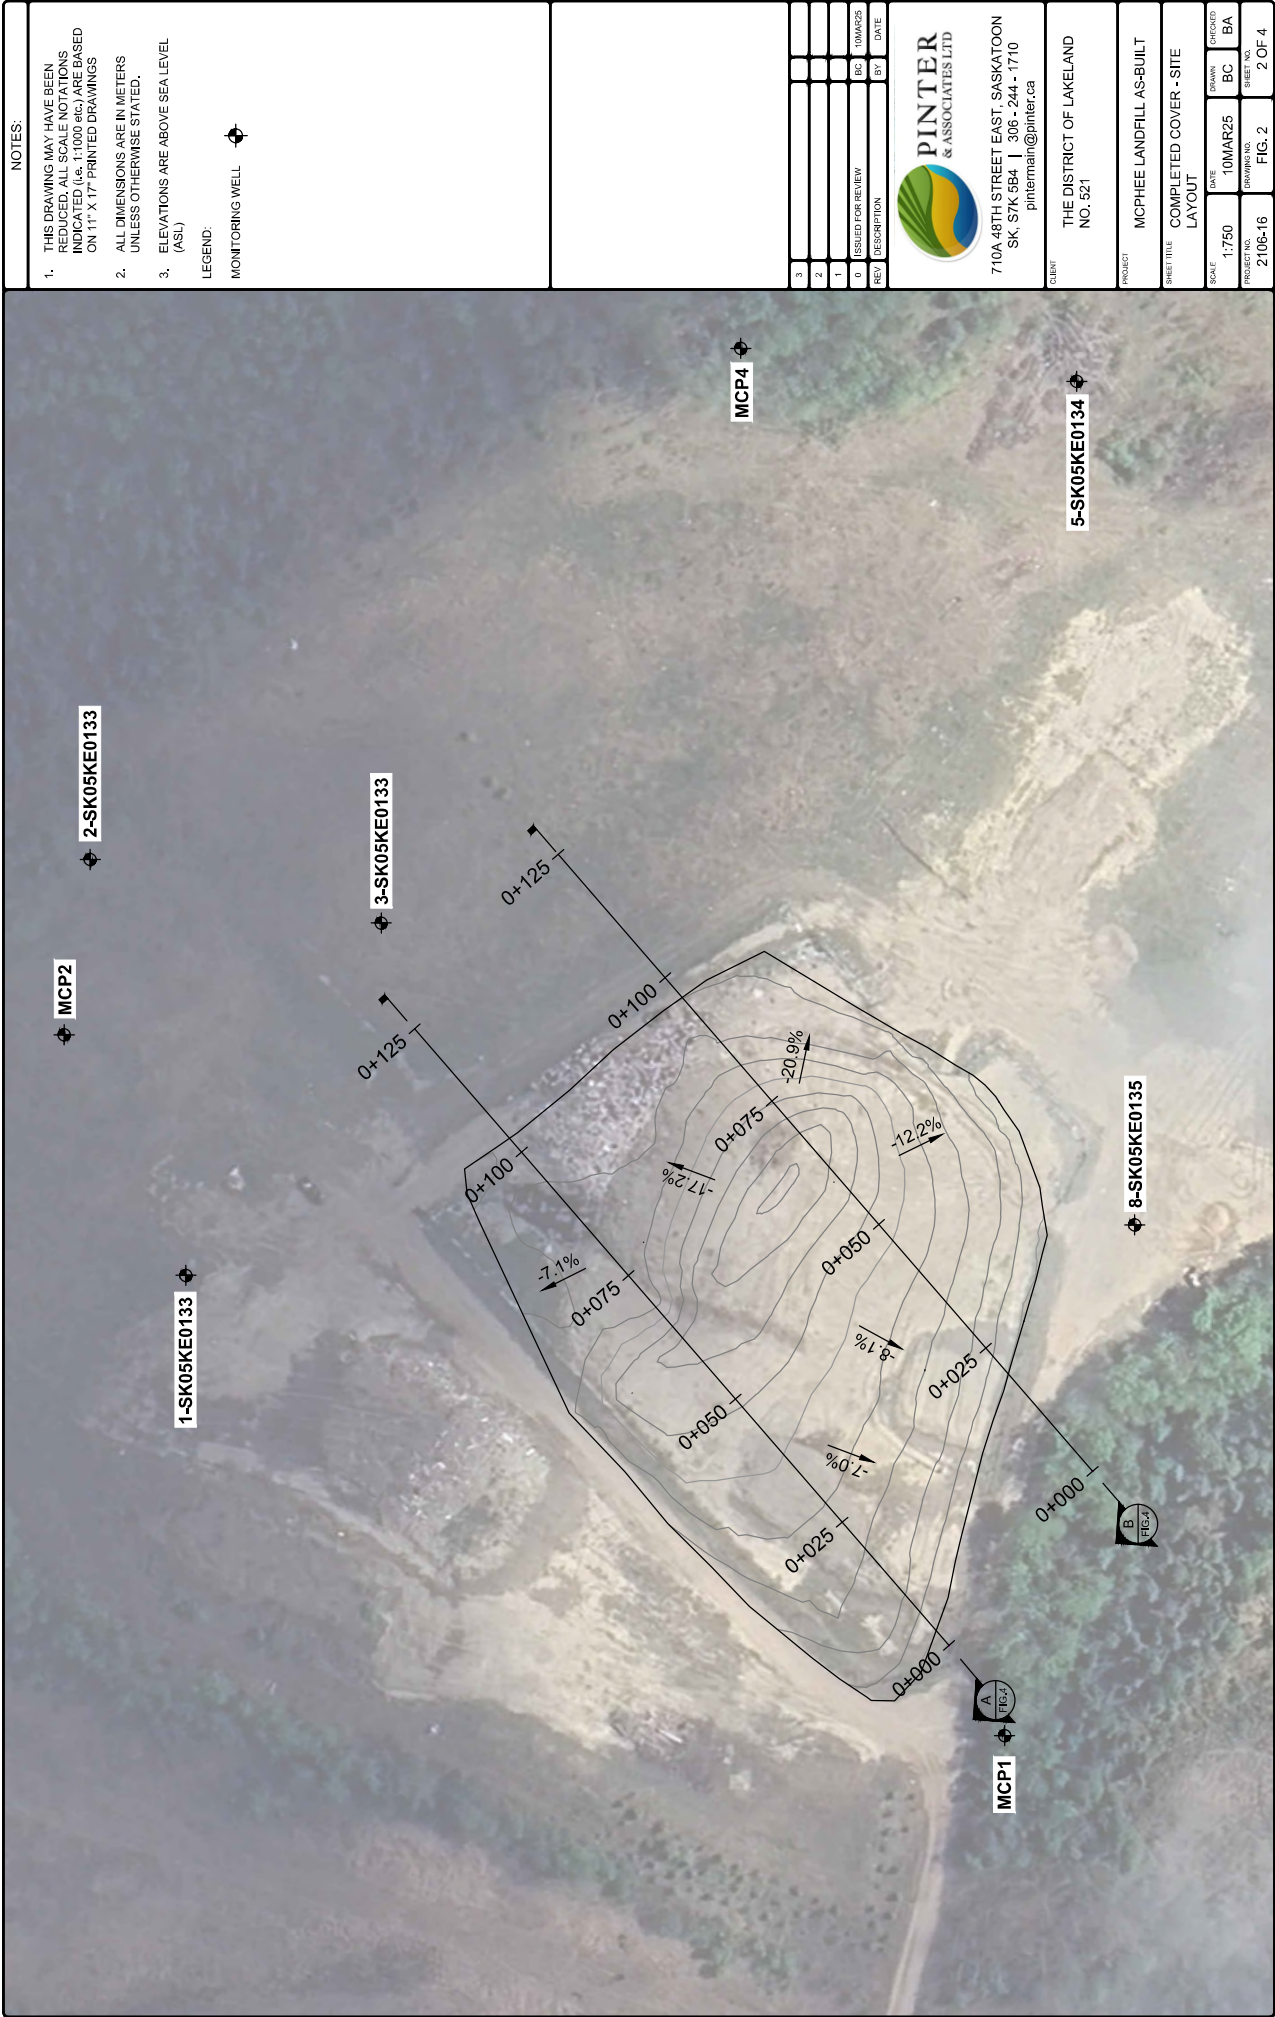


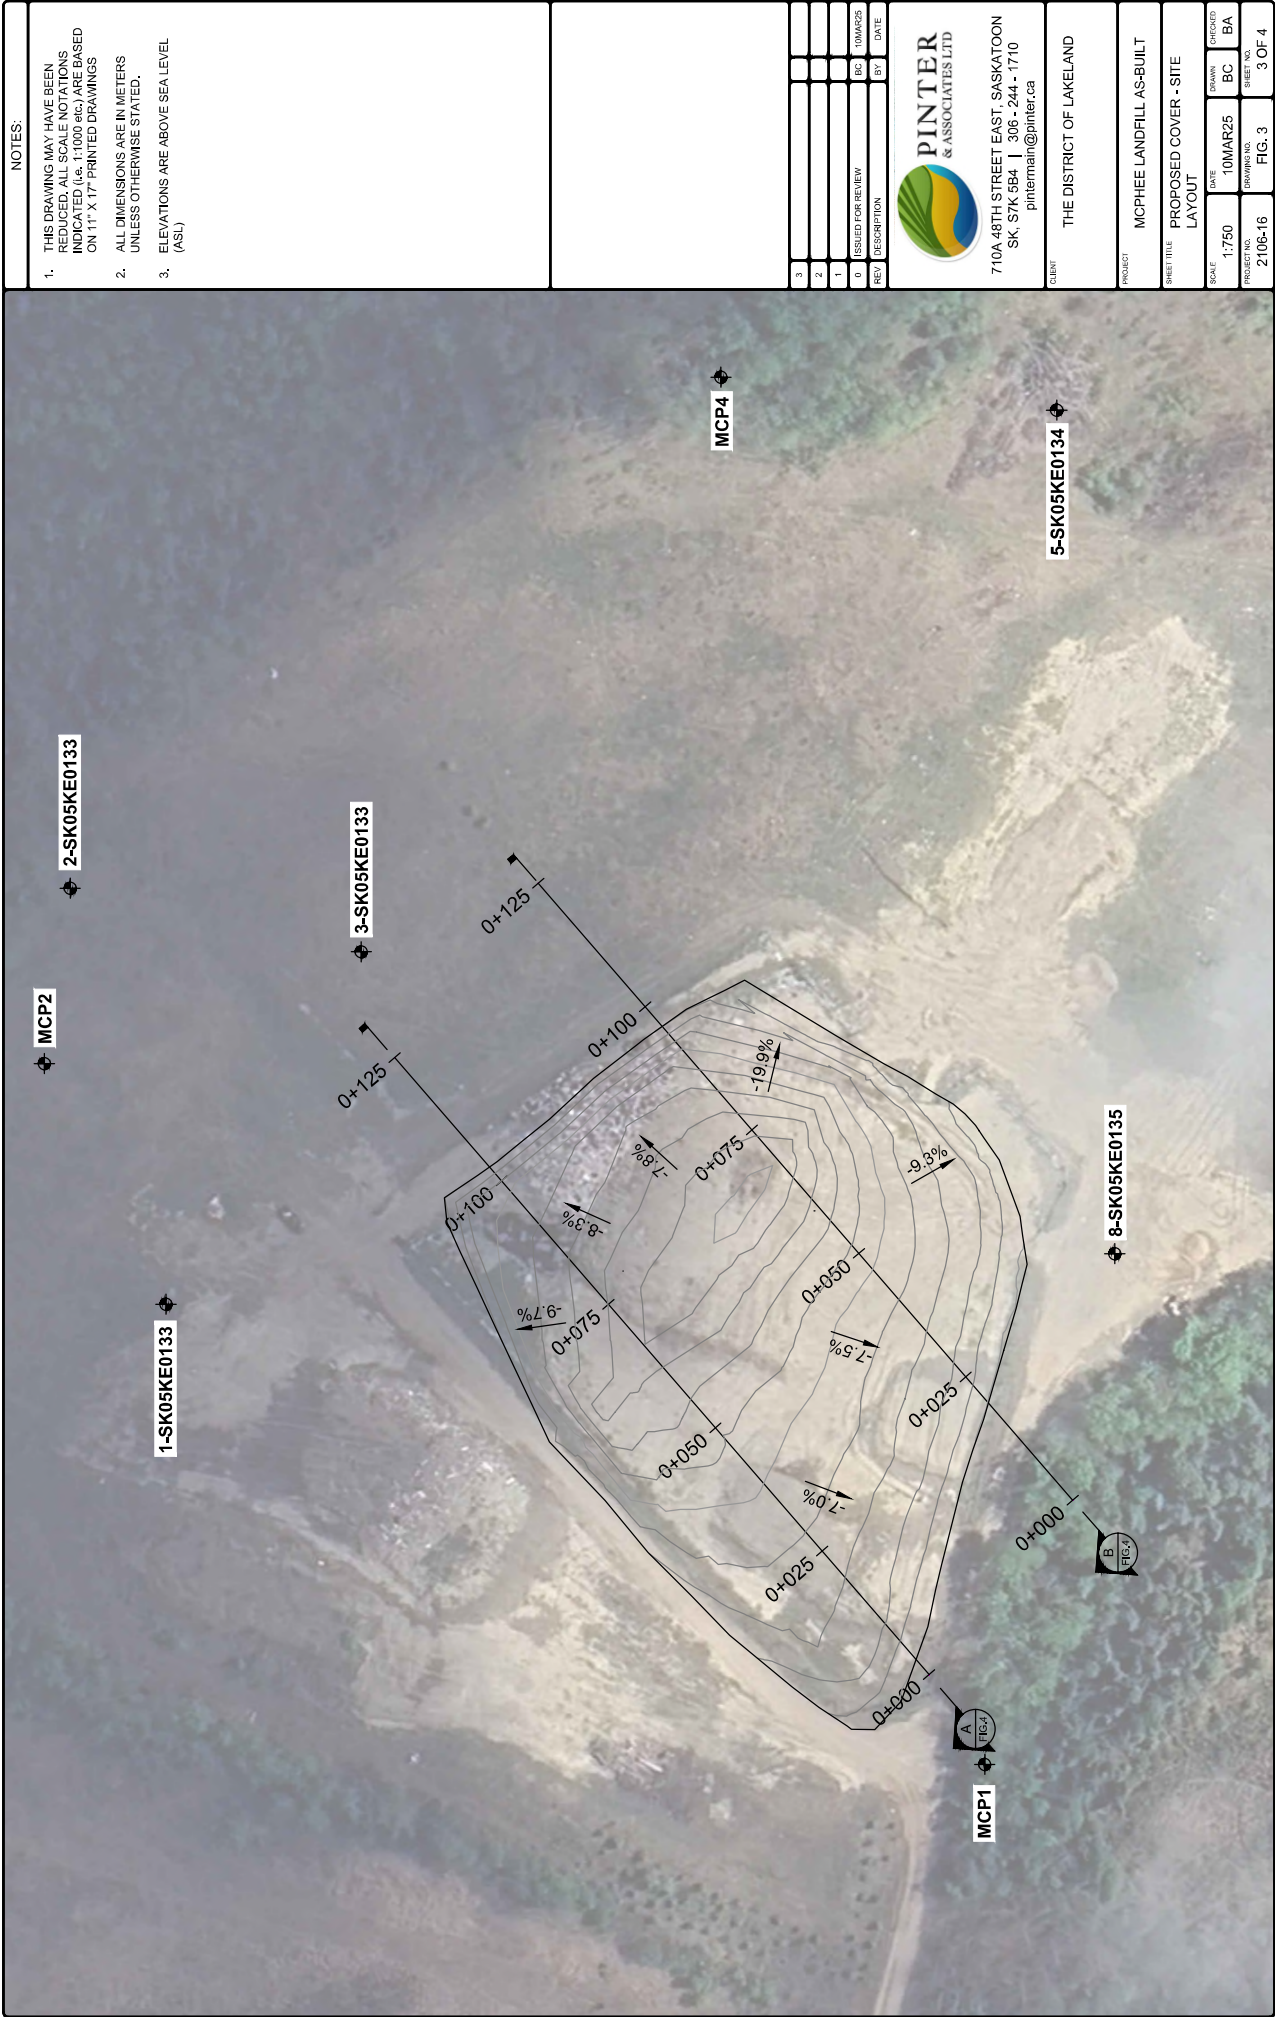

NOTES:	
1.	THIS DRAWING MAY HAVE BEEN REDUCED ALL SCALE NOTATIONS TO 1/4" = 1' UNLESS OTHERWISE INDICATED ON 11" X 17" PRINTED DRAWINGS
2.	ALL DIMENSIONS ARE IN METERS UNLESS OTHERWISE STATED.
3.	ELEVATIONS ARE ABOVE SEA LEVEL (ASL)
LEGEND:	
MONITORING WELL	
3	
2	
1	
0	ISSUED FOR REVIEW
REV	DESCRIPTION
BY	DATE
710A 48TH STREET EAST, SASKATOON SK, S7K 6B4 306 - 244 - 1710 pintermain@pinter.ca	
CLIENT	THE DISTRICT OF LAKELAND NO. 521
PROJECT	MCPHEE LANDFILL AS-BUILT
SHEET TITLE	COMPLETED COVER - SITE LAYOUT
SCALE	1:750
DATE	10MAR25
BY	BC
CHECKED	BA
PROJECT NO.	2106-16
FIG.	FIG. 2
SHEET NO.	2 OF 4

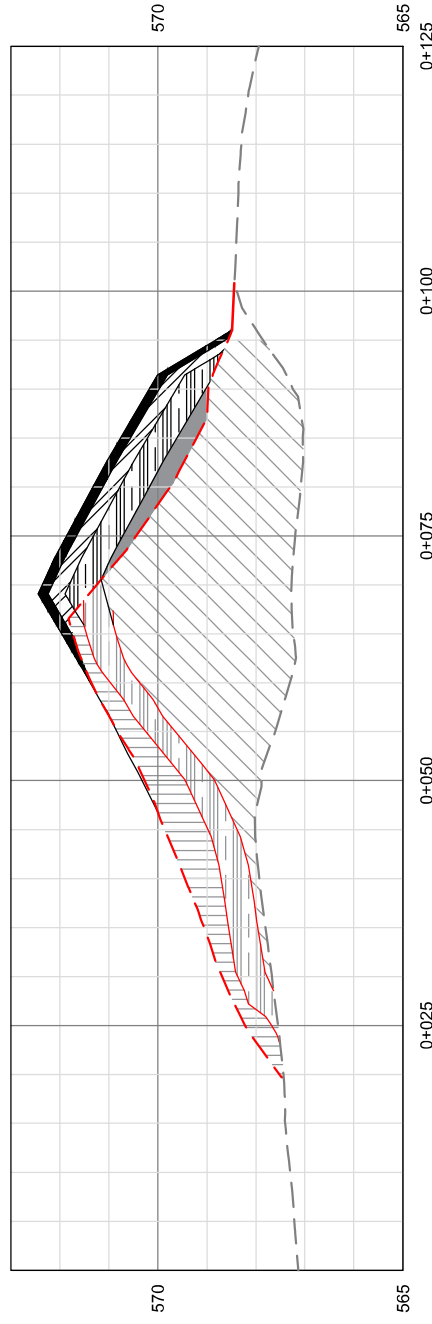

NOTES:	
1.	THIS DRAWING MAY HAVE BEEN REDUCED. ALL SCALE NOTATIONS MUST BE CHECKED AND RELEASED ON 11" X 17" PRINTED DRAWINGS.
2.	ALL DIMENSIONS ARE IN METERS UNLESS OTHERWISE STATED.
3.	ELEVATIONS ARE ABOVE SEA LEVEL (ASL).
3	
2	
1	
0	ISSUED FOR REVIEW
REV	DESCRIPTION
BC	10/MAR/25
BY	DATE
 PINTER & ASSOCIATES LTD 710A 48TH STREET EAST, SASKATOON SK, S7K 6B4 306 - 244 - 1710 pintermain@pinter.ca	
CLIENT: THE DISTRICT OF LAKELAND	
PROJECT: MCPHEE LANDFILL AS-BUILT	
SHEET TITLE: PROPOSED COVER - SITE LAYOUT	
SCALE: 1:750	DATE: 10/MAR/25
PROJECT: 2106-16	FIG. 3
3 OF 4	

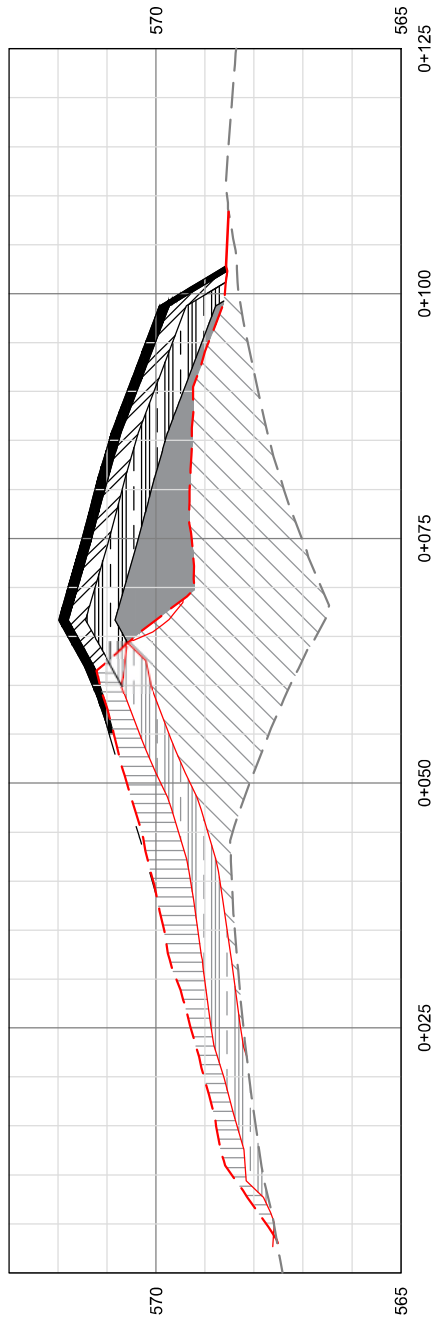

NOTES:

1. THIS DRAWING MAY HAVE BEEN REDUCED, ALL SCALE NOTATIONS INDICATED (i.e. 1:1000 etc.) ARE BASED ON 11" X 17" PRINTED DRAWINGS
2. ALL DIMENSIONS ARE IN METERS UNLESS OTHERWISE STATED.

3. ELEVATIONS ARE ABOVE SEA LEVEL (ASL)

LEGEND:

COMPLETED FILL

PROPOSED FILL

COMPLETED CLAIMS

PROPOSED CLAY

COMPLETED TOPSOIL

& SUBSOIL

PROPOSED SUBSOIL

PROPOSED TOPSOIL

EXISTING GROUND 2018

EXISTING GROUND 2025

3			
2			
1			
0	ISSUED FOR REVIEW	BC	10MAR25
REV.	DESCRIPTION	RV	DATE



PINTER
& ASSOCIATES LTD.

710A 48TH STREET EAST, SASKATOON
SK, S7K 5B4 | 306 - 244 - 1710
pintermain@pinter.ca

CLIENT

THE DISTRICT OF LAKE LAND

PROJECT

MCPHEE LANDFILL AS-BUILT

SHEET 11

PROFILE VIEWS

SCALE

DATE	10MAR25	DRAWN	BC	CHK
------	---------	-------	----	-----

PROJECT

DRAWING NO. 6-16
FIG. 4
SHEET NO. 4 OF 4